

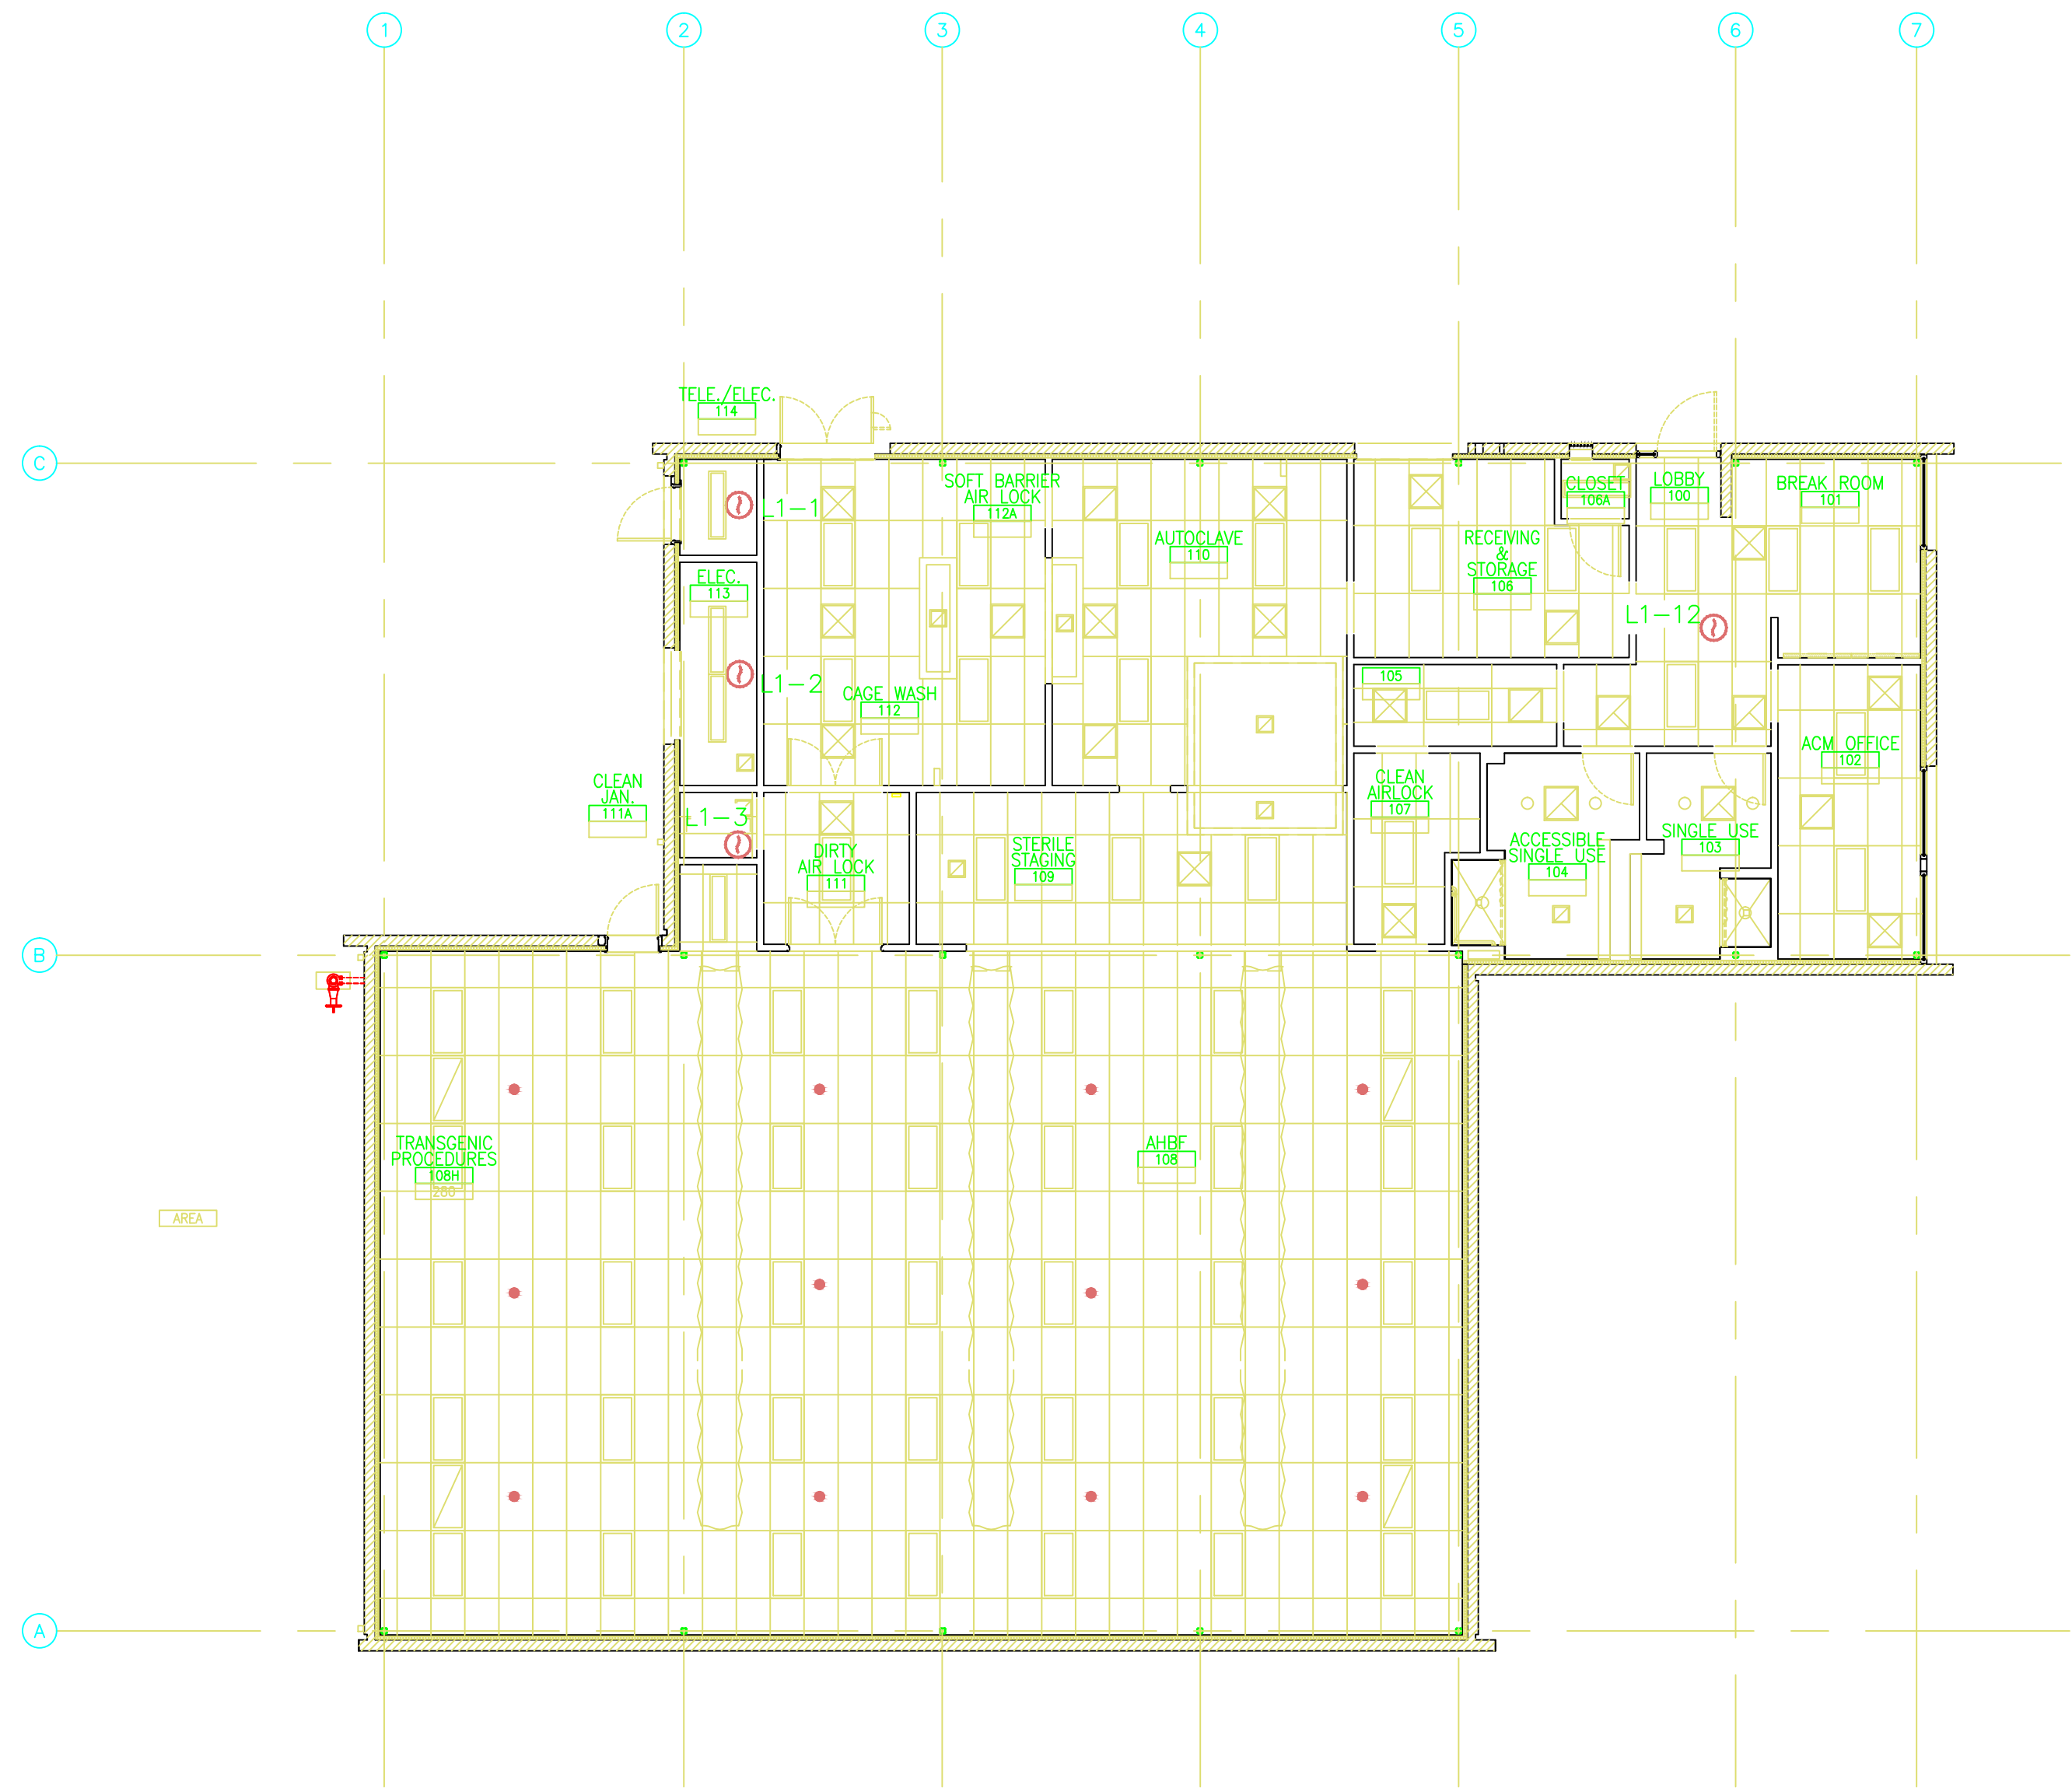


1 FIRE ALARM AND VESDA PLAN
NTS

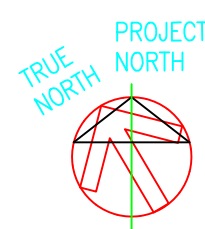

2 FIRE ALARM AND VESDA REFLECTED CEILING PLAN
NTS

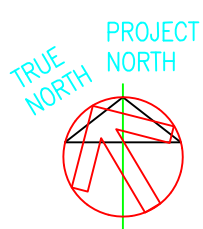

PROFESSIONAL SEAL (IF REVISION, APPLIES ONLY TO REVISED WORK)	ISSUE (PROGRESS, ESTIMATE, BD, CONSTRUCTION, CONFORMED, REVISION, RECORD)	AS BUILT — 07/19/2013						BLDG 86 FIRE ALARM VESDA FLOOR & CEILING PLANS		DRAWN BY DSV		DATE 07/19/2013	
										CHECKED BY LDD		07/23/2013	
										APPROVED BY MCD		07/23/2013	
										SCALE AS NOTED			
										UNIVERSITY OF CALIFORNIA LAWRENCE BERKELEY NATIONAL LABORATORY			
										FACILITIES DIVISION			
		AS BUILT FROM A/E RECORD DWG								DRAWING NO. 4B86E027_		SHEET 3	
										PROJECT NO. FM5500		3 OF 4	